




Wärmeverbund Sagiweg, 4917 Melchnau

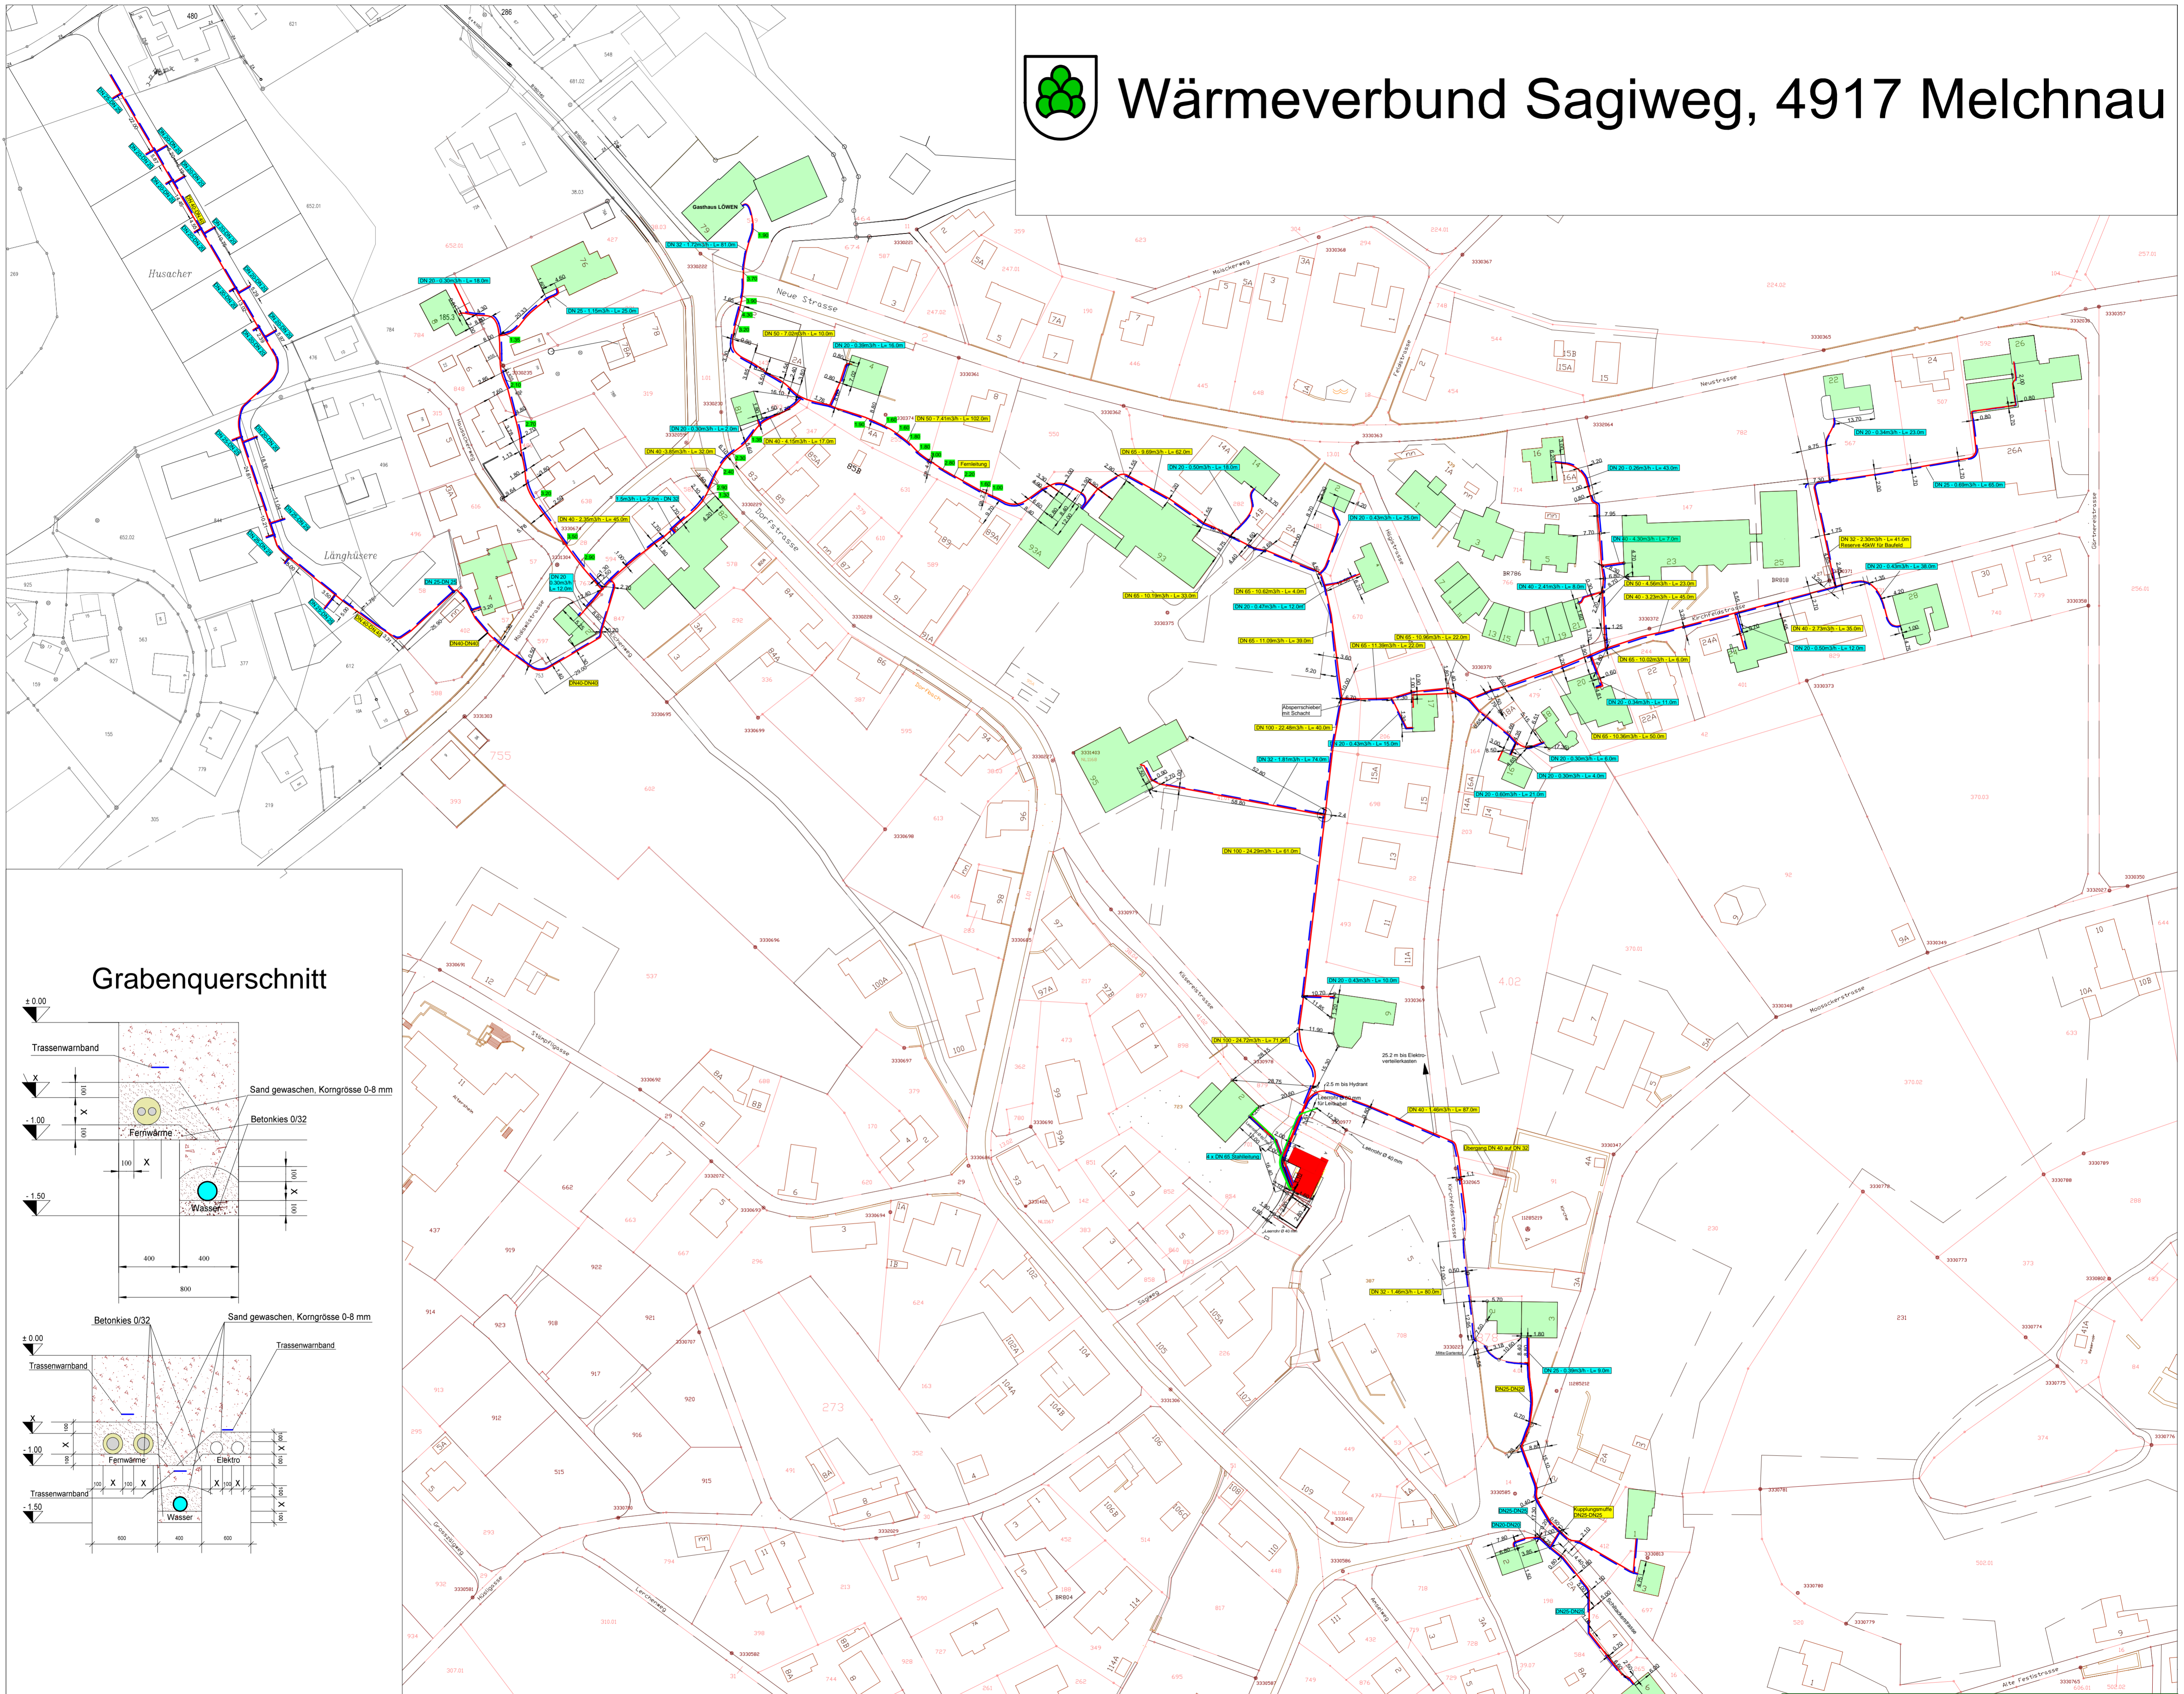


Grabenquerschnitt

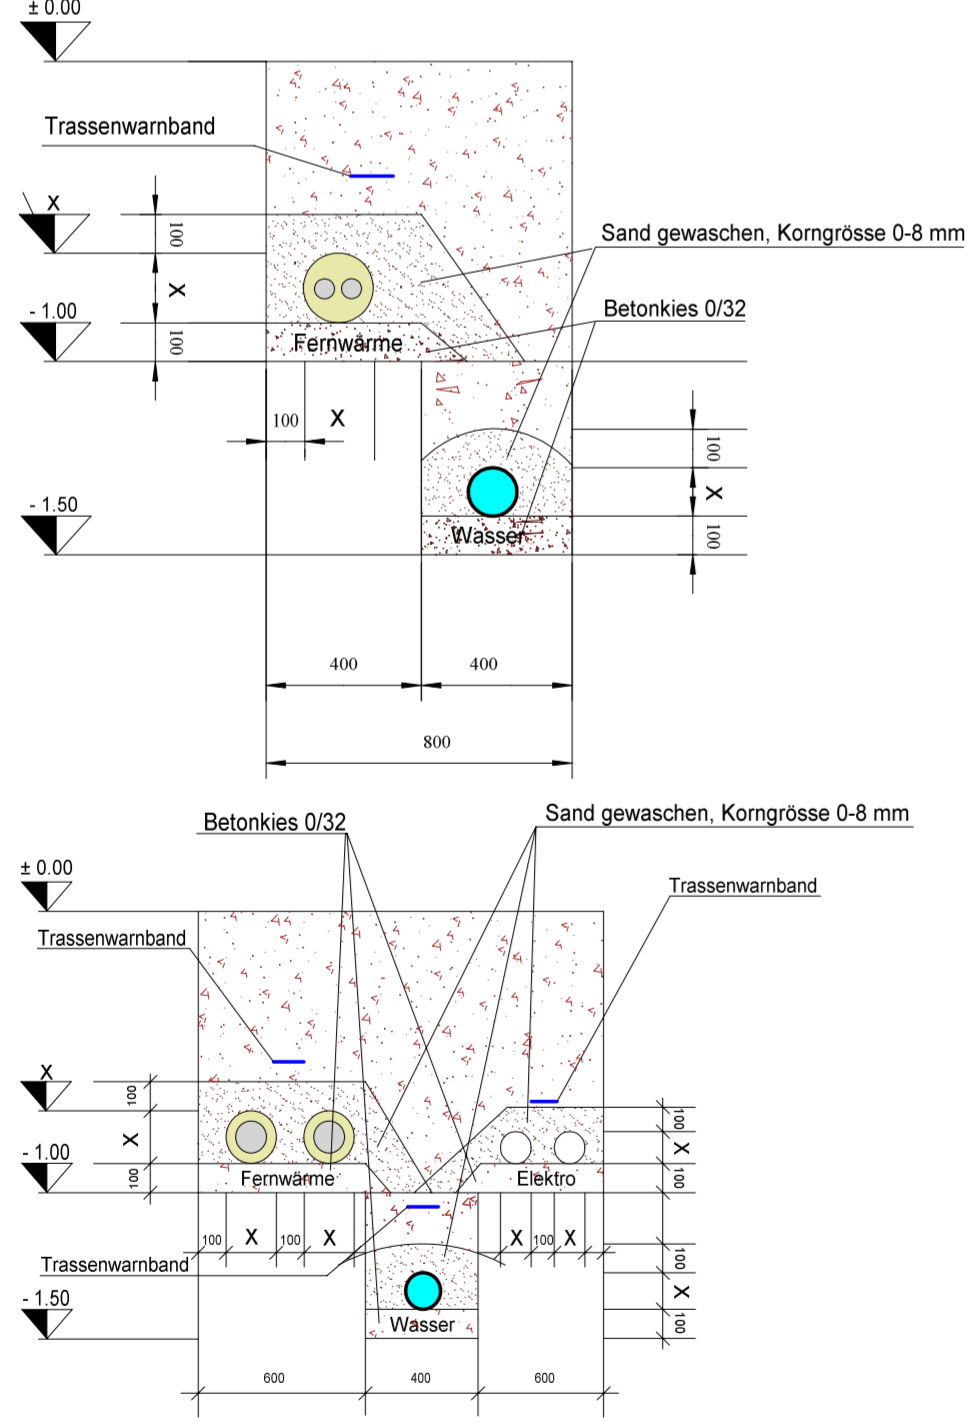

- Legende**
- = ARA
 - = Tiefenangabe
 - = Stammleitungen
 - = Hausanschlussleitungen

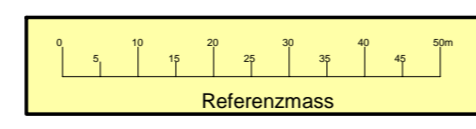

CALPEX - Fernwärmeleitungen	Innenrohr	Aussenrohr
DN 20 DUO 2 x 3/4"	25 x 2.3	93 x 2.3
DN 25 DUO 2 x 1"	32 x 2.9	113 x 2.9
DN 32 DUO 2 x 1 1/4"	40 x 3.7	128 x 2.7
DN 40 DUO 2 x 1 1/2"	50 x 4.6	163 x 3.2
DN 50 DUO 2 x 2"	63 x 5.8	183 x 3.3
DN 65 UNO 2 1/2"	75 x 6.8	143 x 3.0
DN 80 UNO 3"	90 x 8.2	163 x 3.2
DN 100 UNO 4"	110 x 10	163 x 3.2

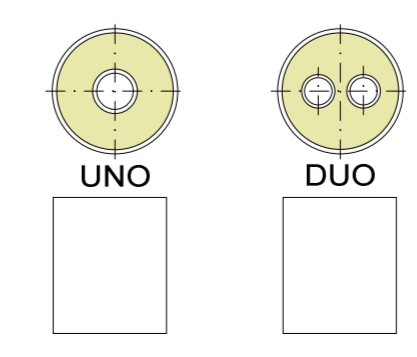

ANLAGE: Wärmeverbund 4917 Melchnau

Revisionsplan

Wärmeverbund	Situationsplan	Rev. Nr.	07.01.2013
Planindex	0004	Format	A0
MST	1:1000	E-Mail	info@gunep.ch

GUNEP GmbH Generalunternehmung für nachhaltige Energieprojekte

Ihre Wahl von heute... für die Welt von morgen

Tel. 061 975 99 66 E-Mail info@gunep.ch
 Fax. 061 975 99 67 Internet: www.gunep.ch